

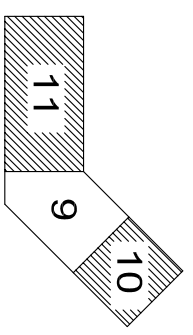


- NOTES:-**
- (1) REF. DESIGN DWG. NO S1035 & S1036.
  - (2) REF. ERECTION DWG. NO. E11,E12 FOR SECTION DETAIL
  - (3) PLEASE PROVIDE/VERIFY ALL CLOUDED DIMENSIONS.
  - (4) REF. ERECTION DWG NO.E9 FOR BRACES ELEV. AND MKD.

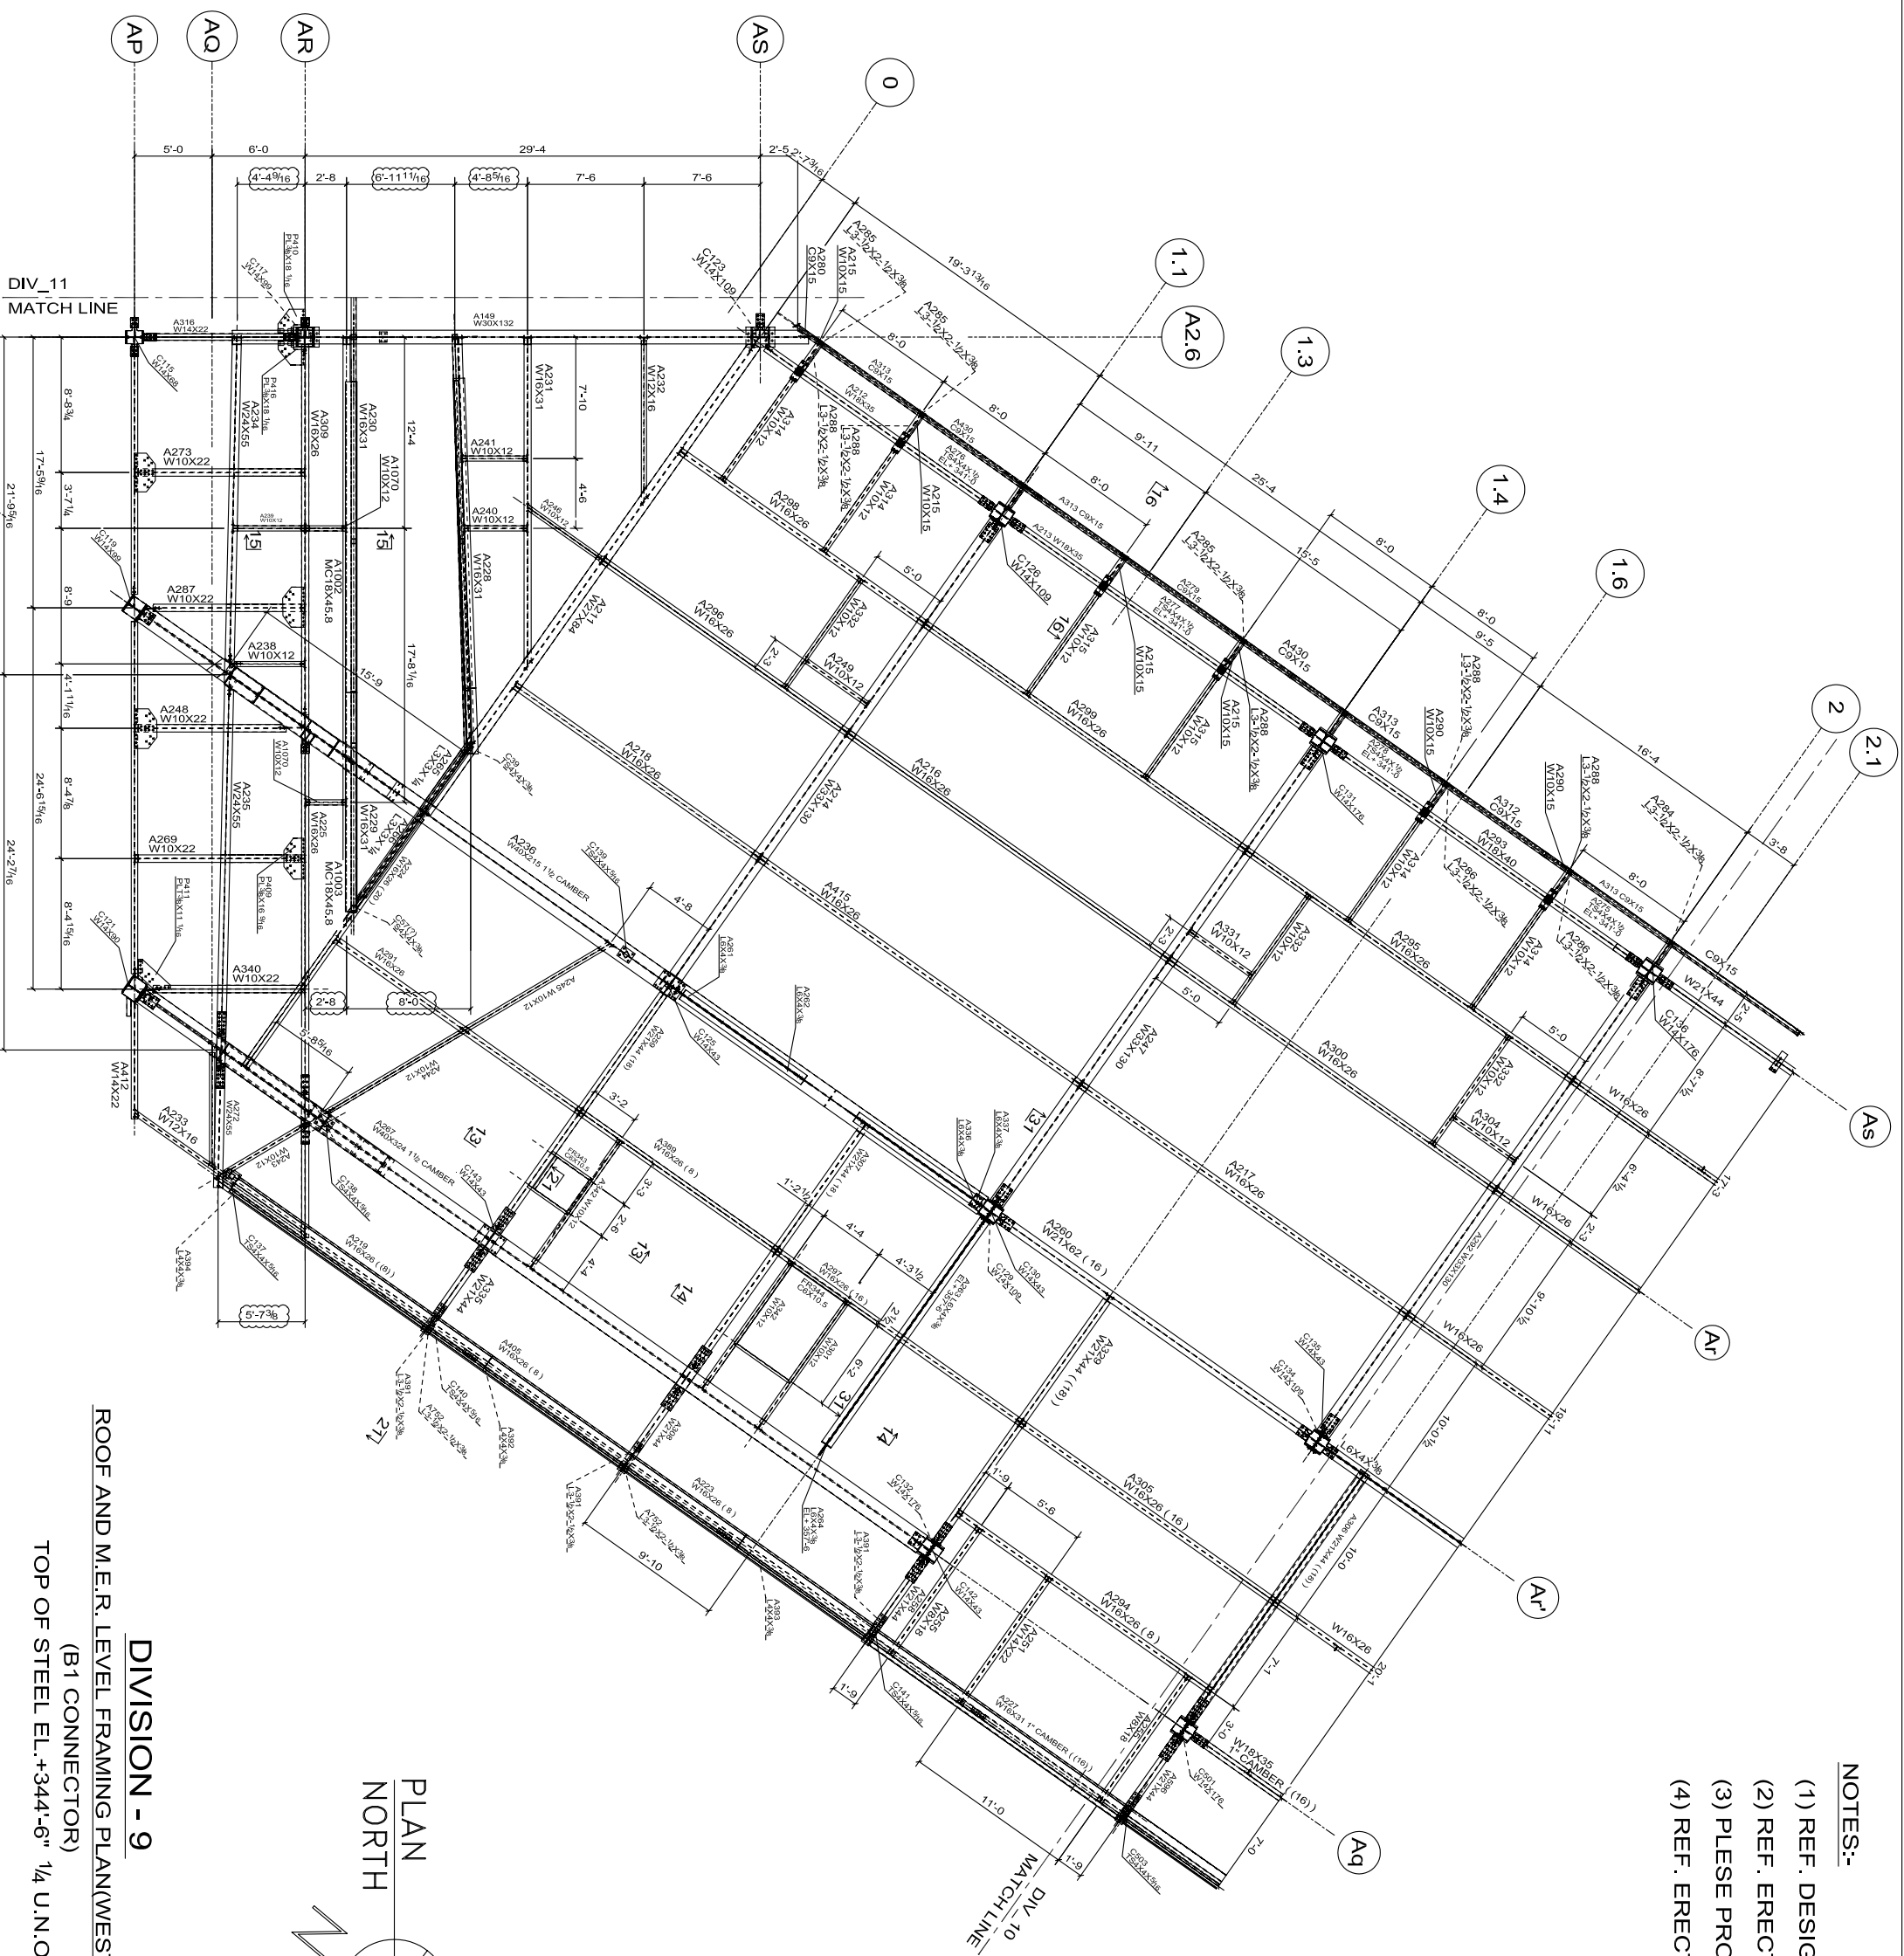

**KEY PLAN**

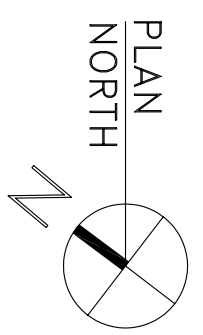

**DIVISION - 9**

**ROOF AND M.E.R. LEVEL FRAMING PLAN(WEST & EAST)**  
 (B1 CONNECTOR)  
 TOP OF STEEL EL.+344'-6" 1/4 U.N.O.

△	FABRICATION	VKN	12-14-07
△	FABRICATION	P.K.	11-21-07
△	APPROVAL	P.K.	09-24-07
REV.	DESCRIPTION	BY	DATE

**CUSTOMER**

**PROJECT**  
 NEWARK LIBERTY  
 INTERNATIONAL AIRPORT

**SUBJECT**  
 ERECTION PLAN  
 FOR B1 CONNECTOR

<b>DRAWN BY</b>	<b>CHECKED BY</b>	<b>DATE</b>
P.K.	DN	12-14-07
<b>CONTRACT #</b>	<b>DRAWING #</b>	<b>ISSUE</b>
1183	E4	1