


2 - COLUMNS - 707C1

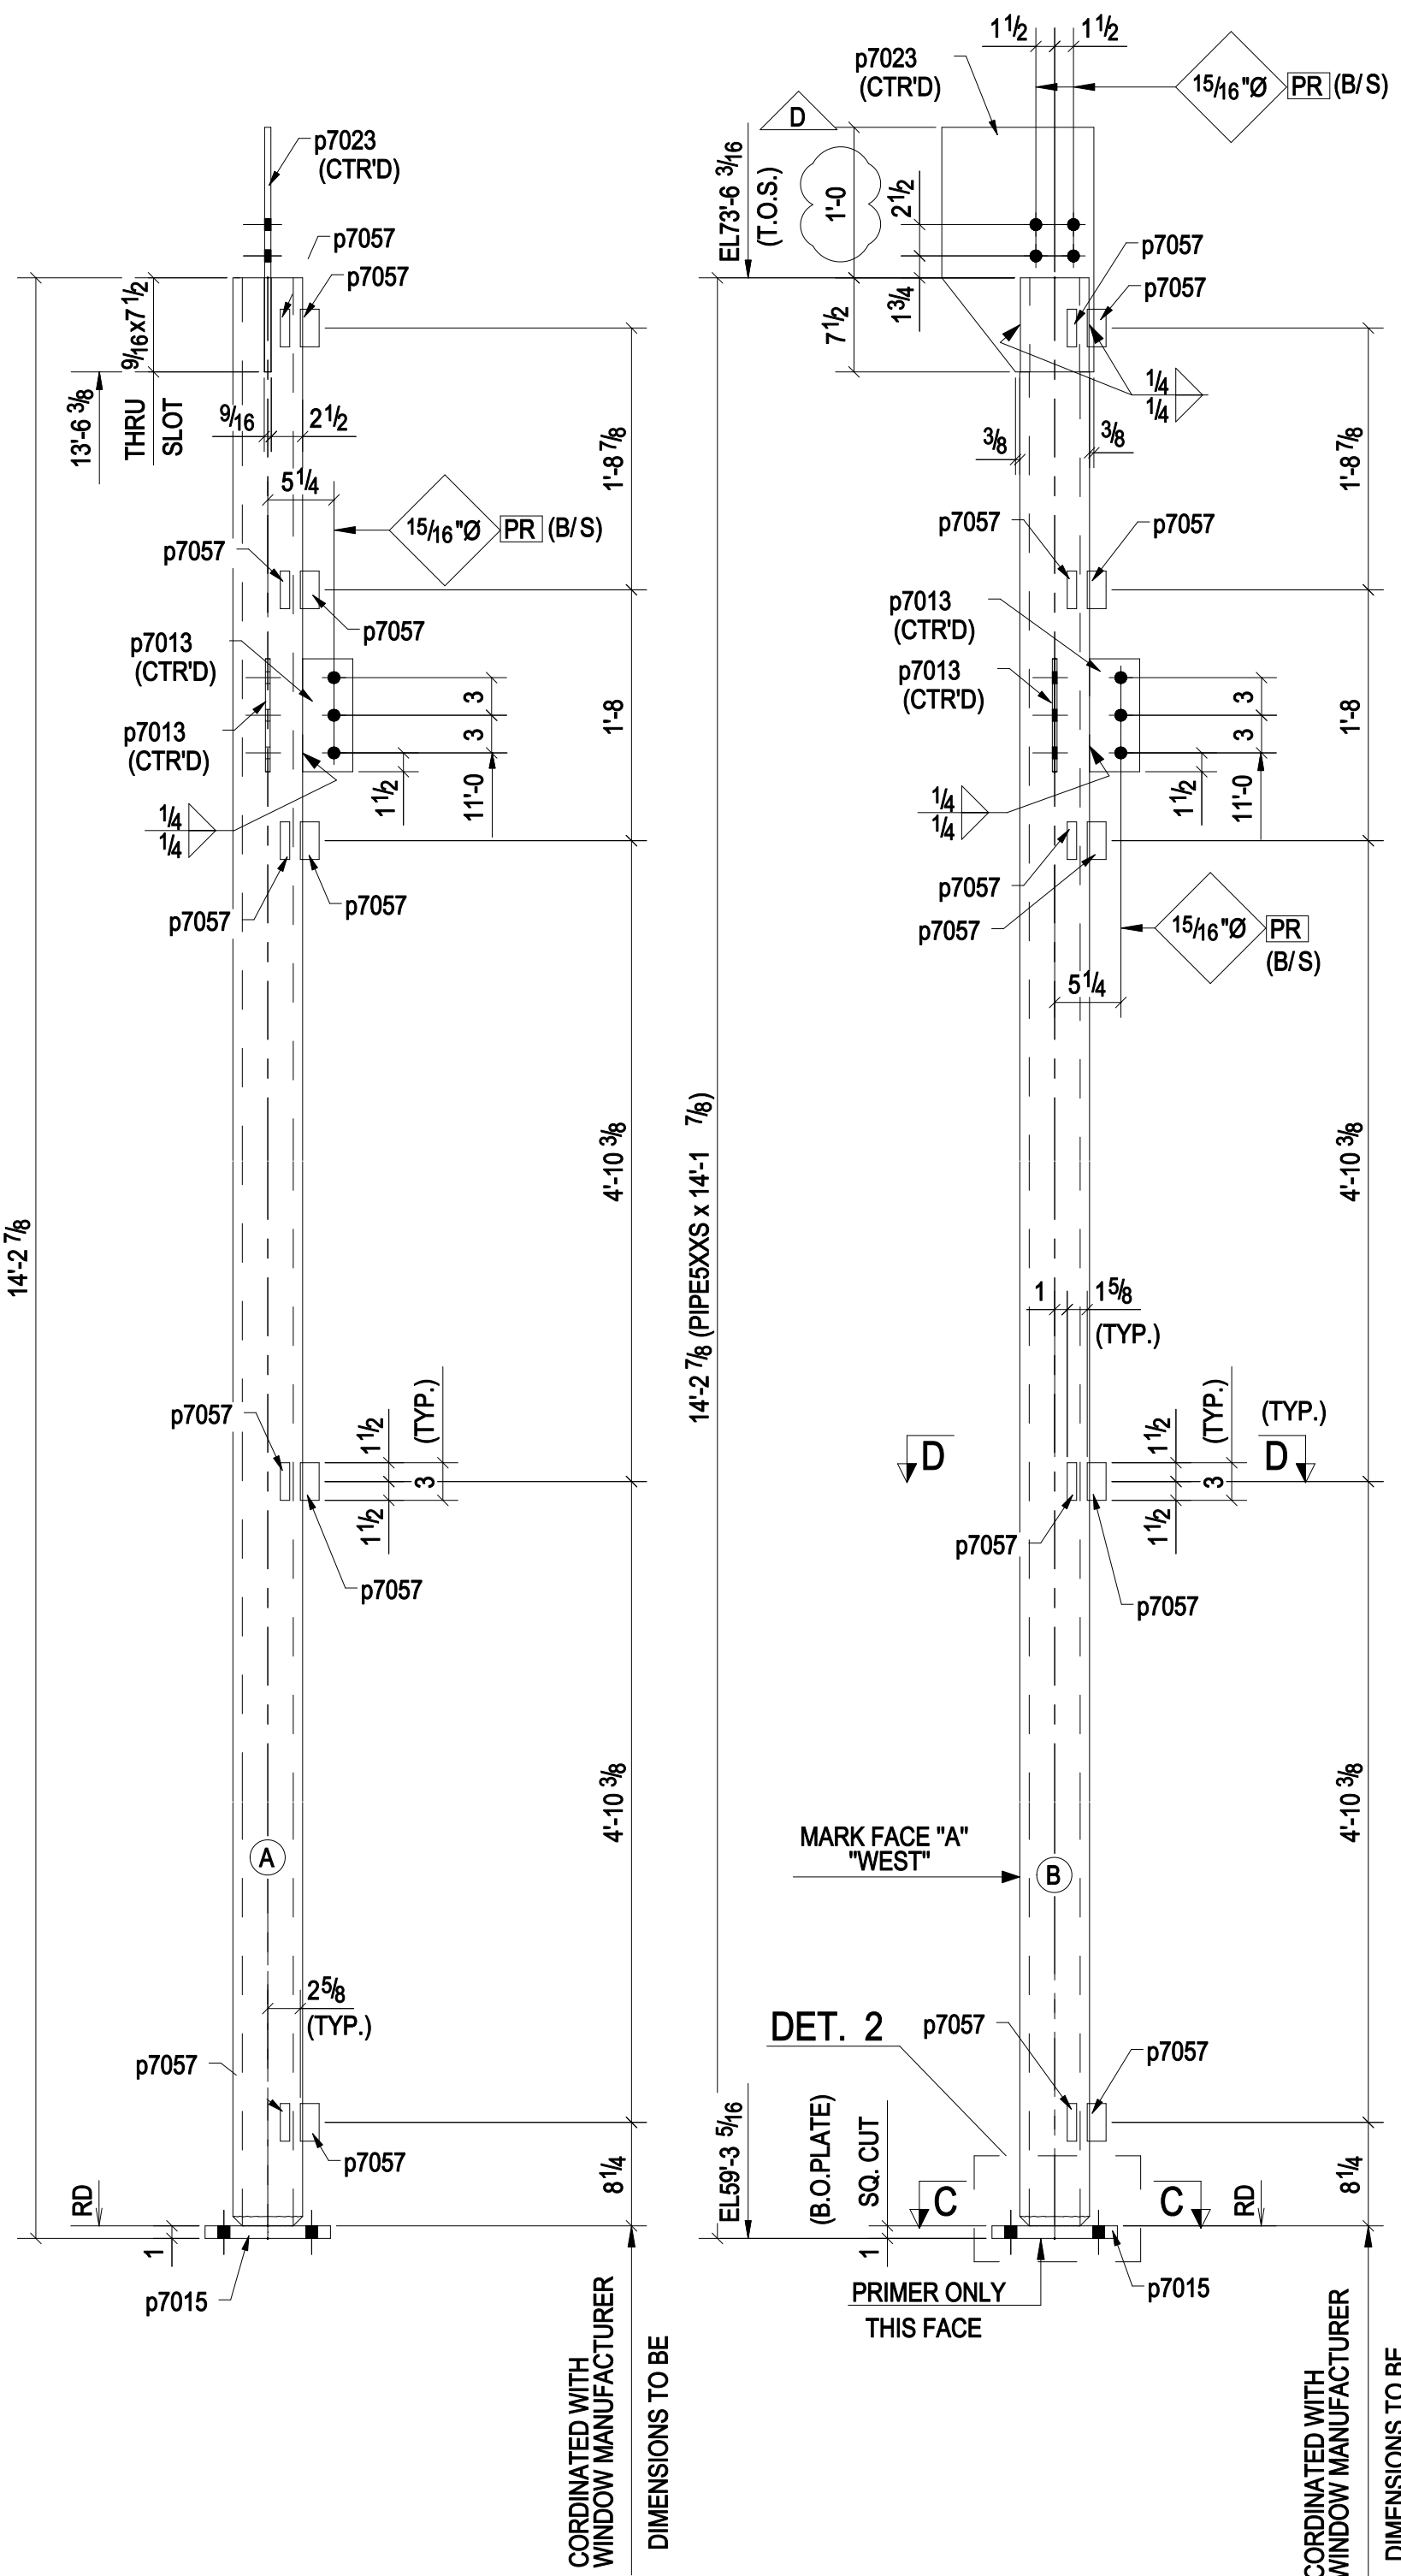

ONE - COLUMN - 707C2

NOTE 1: APPROVER PLEASE PROVIDE DIMENSION


SURFACE FINISH: SSPC-SP6

PAINT SYSTEM-1

- (I) PRIMER CARBOZINC 859 2.5 TO 3.5 MILS DFT.
- (II) TOP COAT CARBOGUARD 893SG 4.0 TO 6.0 MILS DFT.
- (III) COLOR UTILITY TOOLBOX C703 MEDIUM GRAY.

BILL OF MATERIAL

| Qty | Ship Mark | Qty Unit | DESCRIPTION | Weight lbf | LENGTH | Grade | REMARKS |
|-------|-----------|----------|---------------------------|------------|------------|----------|---------|
| 707C1 | | 2 | PIPE5XXS | 1031.00 | 14'-1 7/8" | A53-GR.B | |
| 4 | p7013 | 4 | FL3/8"X4" | 15.31 | 0'-9" | A36 | |
| 2 | p7015 | 2 | FL1"X10" | 56.72 | 0'-10" | A36 | |
| 2 | p7023 | 2 | PL1/2"X12 1/8" | 60.81 | 1'-7 1/2" | A36 | |
| 20 | p7057 | 20 | FL3/4"X1 1/2" | 19.14 | 0'-3" | A36 | |
| | | 8 | 7/8"Ø A325SC BOLT | | 0'-3" | Site | |
| 707C2 | | 1 | PIPE5XXS | 515.50 | 14'-1 7/8" | A53-GR.B | |
| 2 | p7013 | 2 | FL3/8"X4" | 7.66 | 0'-9" | A36 | |
| 1 | p7015 | 1 | FL1"X10" | 28.36 | 0'-10" | A36 | |
| 1 | p7023 | 1 | PL1/2"X12 1/8" | 30.40 | 1'-7 1/2" | A36 | |
| 10 | p7057 | 10 | FL3/4"X1 1/2" | 9.57 | 0'-3" | A36 | |
| | | 4 | 7/8"Ø A325SC BOLT | | 0'-3" | Site | |
| | | | TOTAL WEIGHT THIS DRAWING | 594.61 | | | |

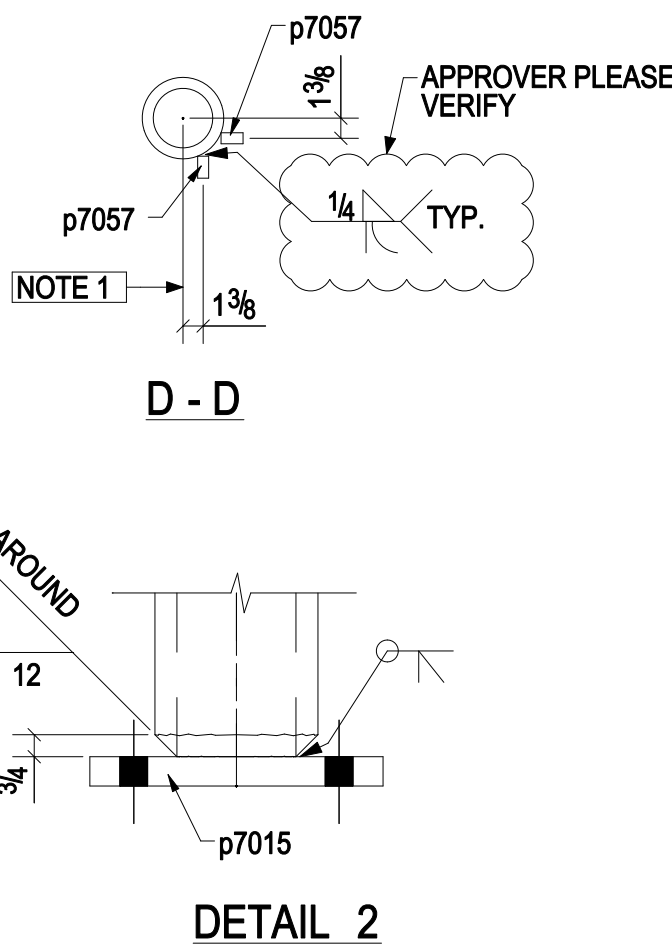

PR INDICATES PRIMER ONLY AREA WITHIN 3" OF OPEN HOLES.

REF: E701

| | | |
|--|-----------------|-----------------------|
| REV: | DATE: | REVISION NOTE: |
| A | 02/04/2015 | FOR APPROVAL |
| B | 02/09/2015 | FOR APPROVAL |
| C | 02/10/2015 | FOR APPROVAL |
| D | 02/16/2015 | REVISED AS MARKED |
| PROJECT: STAMFORD RAILROAD STATION IMPROVEMENTS CITY OF STAMFORD PEDESTRIAN BRIDGE | | |
| PAY ITEM : 0040 (SITE No.1) | | |
| CTDOT PROJECT No: 0301-0157 | | |
| PROJECT NO: 2015-001 | | |
| Customer: | | |
| DRAWN BY: VM DATE: 02/16/2015 | | |
| CHECKED BY: AS DATE: 02/16/2015 | | |
| FABRICATOR: | | |
| JOB NO. 1942-14E REV: D | | |
| DESIGNER: | HOLES: AS NOTED | MATL SPEC. AS NOTED |
| | | WELD CODE: AWS D1.1 |
| DWG SIZE: 914x609 | SCALE: | DRAWING TITLE: COLUMN |
| | | DRAWING: 707 |