

BILL OF MATERIAL


Qty	Ship Mark	Qty Unit	DESCRIPTION	Weight lbf	LENGTH	Grade	REMARKS
704C1		1	PIPE5XXS	515.50	14'-1 7/8"	A53-GR.B	
2	p7013	2	FL3/8"X4"	7.66	0'-9"	A36	
1	p7015	1	FL1"X10"	28.36	0'-10"	A36	
1	p7023	1	PL1/2"X12 1/8"	30.40	1'-7 1/2"	A36	
10	p7057	10	FL3/4"X1 1/2"	9.57	0'-3"	A36	
		4	7/8"Ø A325SC BOLT		0'-3"	Site	
704C2		1	PIPE5XXS	515.50	14'-1 7/8"	A53-GR.B	
2	p7013	2	FL3/8"X4"	7.66	0'-9"	A36	
1	p7015	1	FL1"X10"	28.36	0'-10"	A36	
1	p7023	1	PL1/2"X12 1/8"	30.40	1'-7 1/2"	A36	
10	p7057	10	FL3/4"X1 1/2"	9.57	0'-3"	A36	
		4	7/8"Ø A325SC BOLT		0'-3"	Site	
			TOTAL WEIGHT THIS DRAWING	594.61			

NOTE 1 : APPROVER PLEASE PROVIDE DIMENSION.


PR INDICATES PRIMER ONLY AREA WITHIN 3" OF OPEN HOLES.

REF: E701

REV:	DATE:	REVISION NOTE:
A	02/04/2015	FOR APPROVAL
B	02/09/2015	FOR APPROVAL
C	02/10/2015	FOR APPROVAL
D	02/16/2015	REVISED AS MARKED
PROJECT: STAMFORD RAILROAD STATION IMPROVEMENTS CITY OF STAMFORD PEDESTRIAN BRIDGE		PAY ITEM : 0040 (SITE No.1) CTDOT PROJECT No: 0301-0157 PROJECT NO: 2015-001
Customer:		DRAWN BY: VM DATE: 02/16/2015 CHECKED BY: AS DATE: 02/16/2015
FABRICATOR:		JOB NO. 1942-14E REV: D
DESIGNER:	HOLES: AS NOTED	MAT'L SPEC. AS NOTED
		WELD CODE: AWS D1.1
DWG SIZE: 914x609	SCALE:	
	DRAWING TITLE: COLUMN	
	DRAWING: 704	

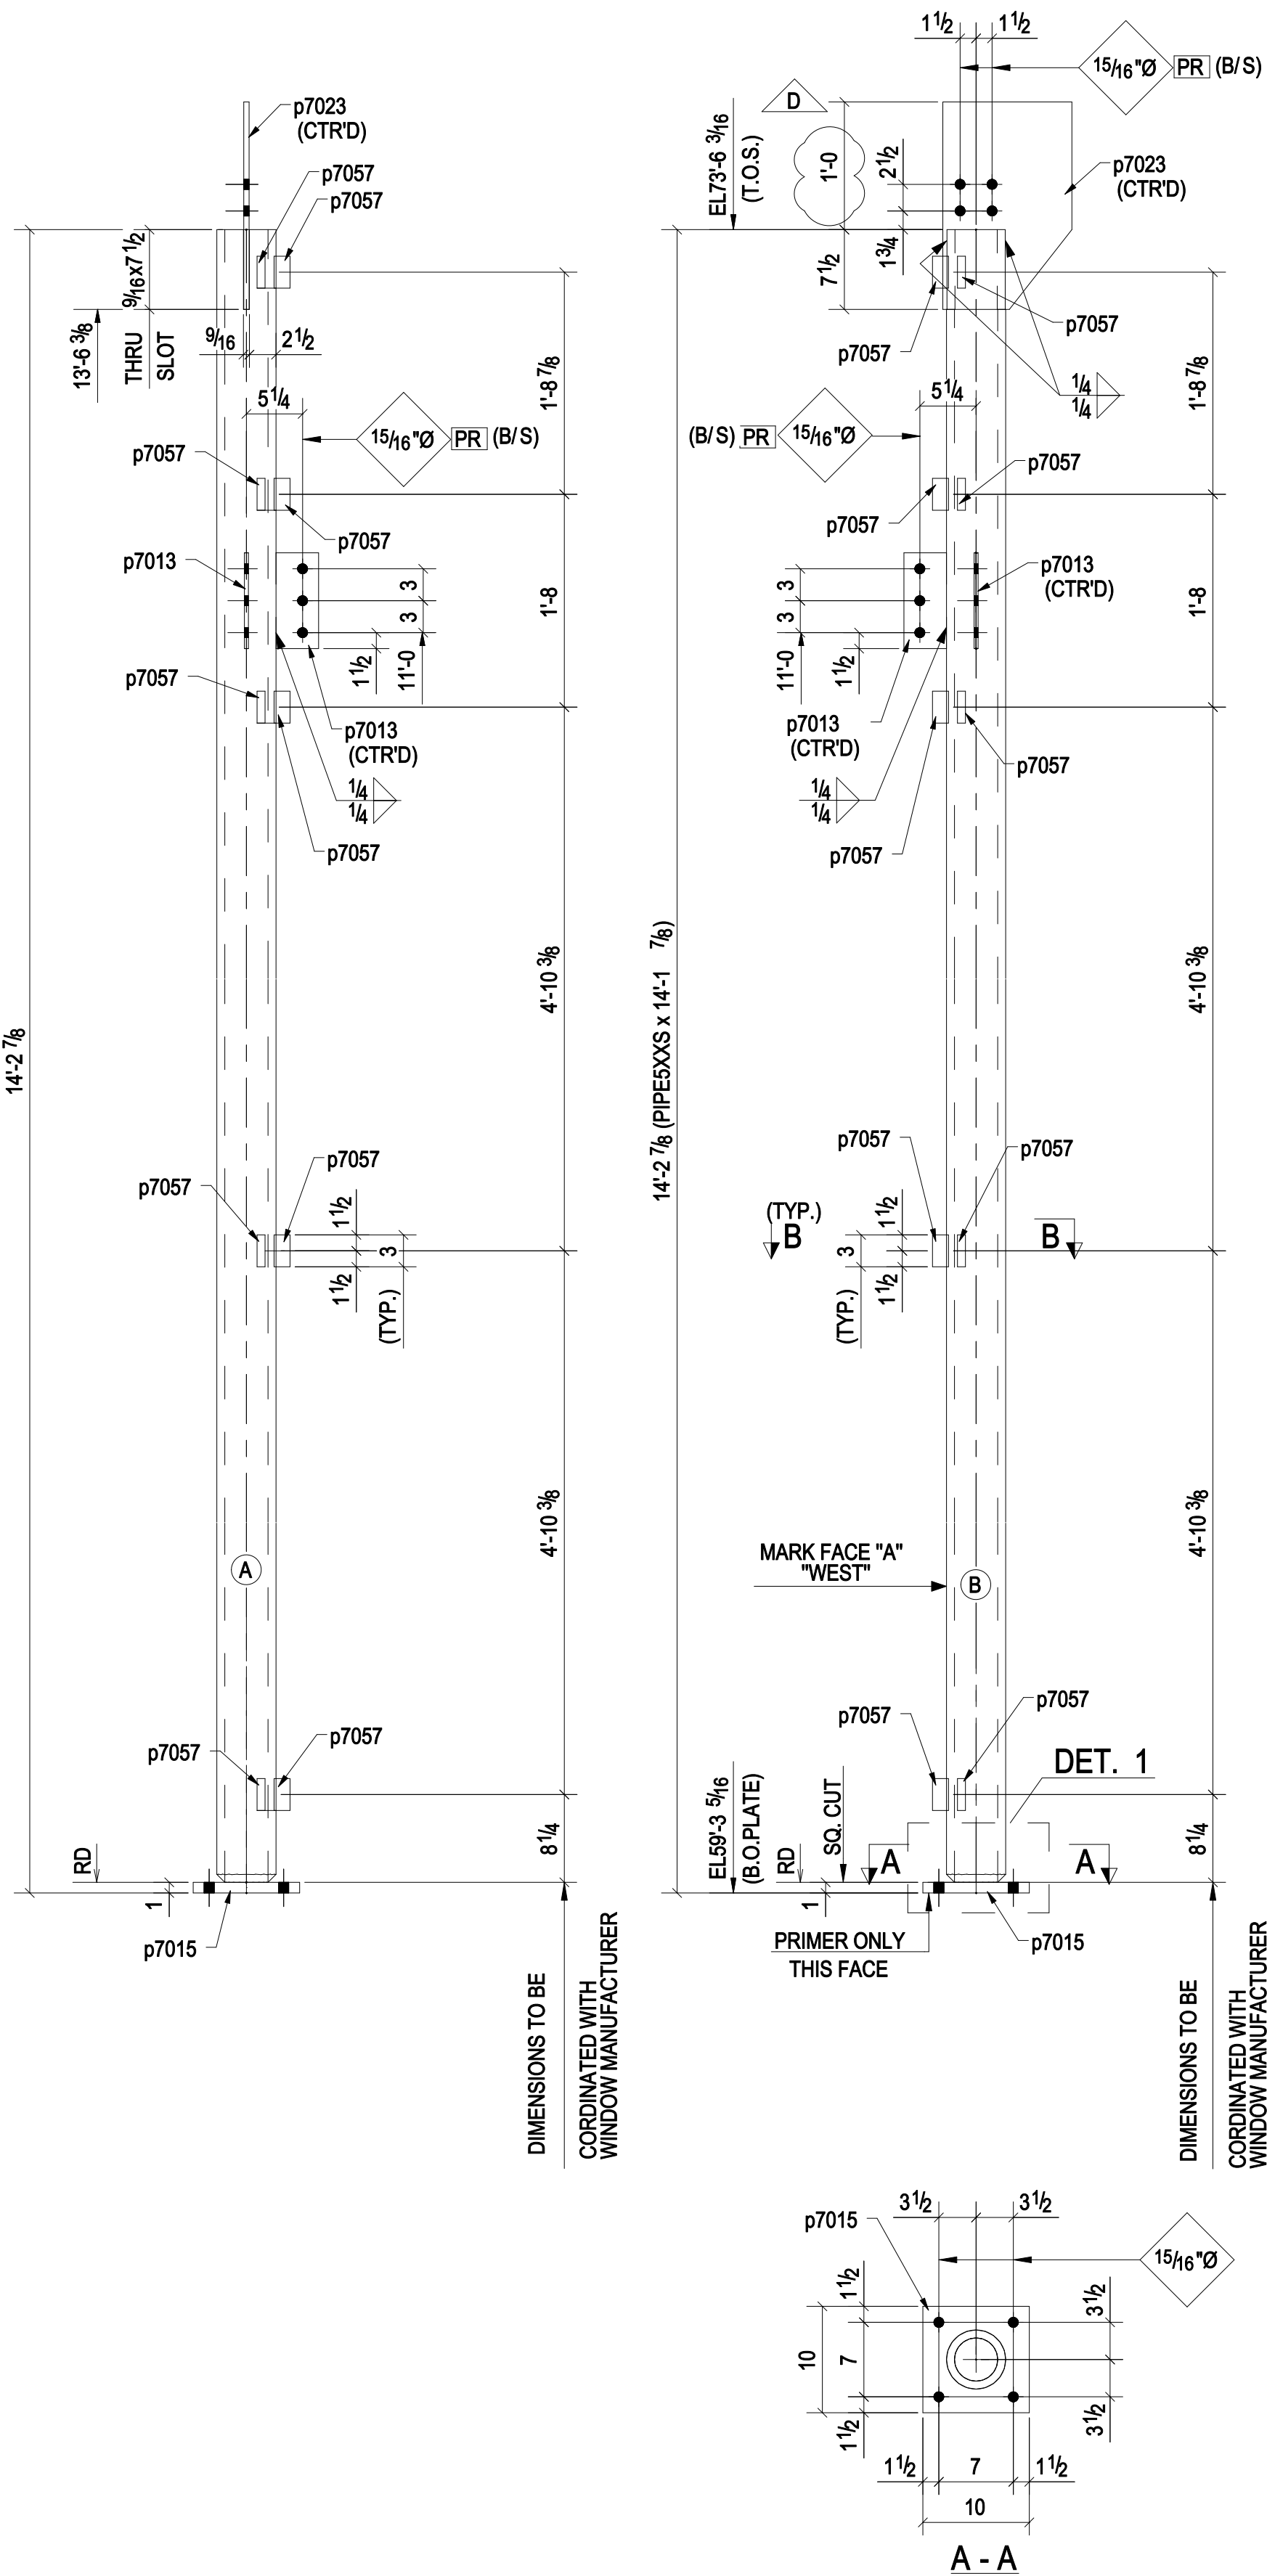

ONE - COLUMN - 704C1

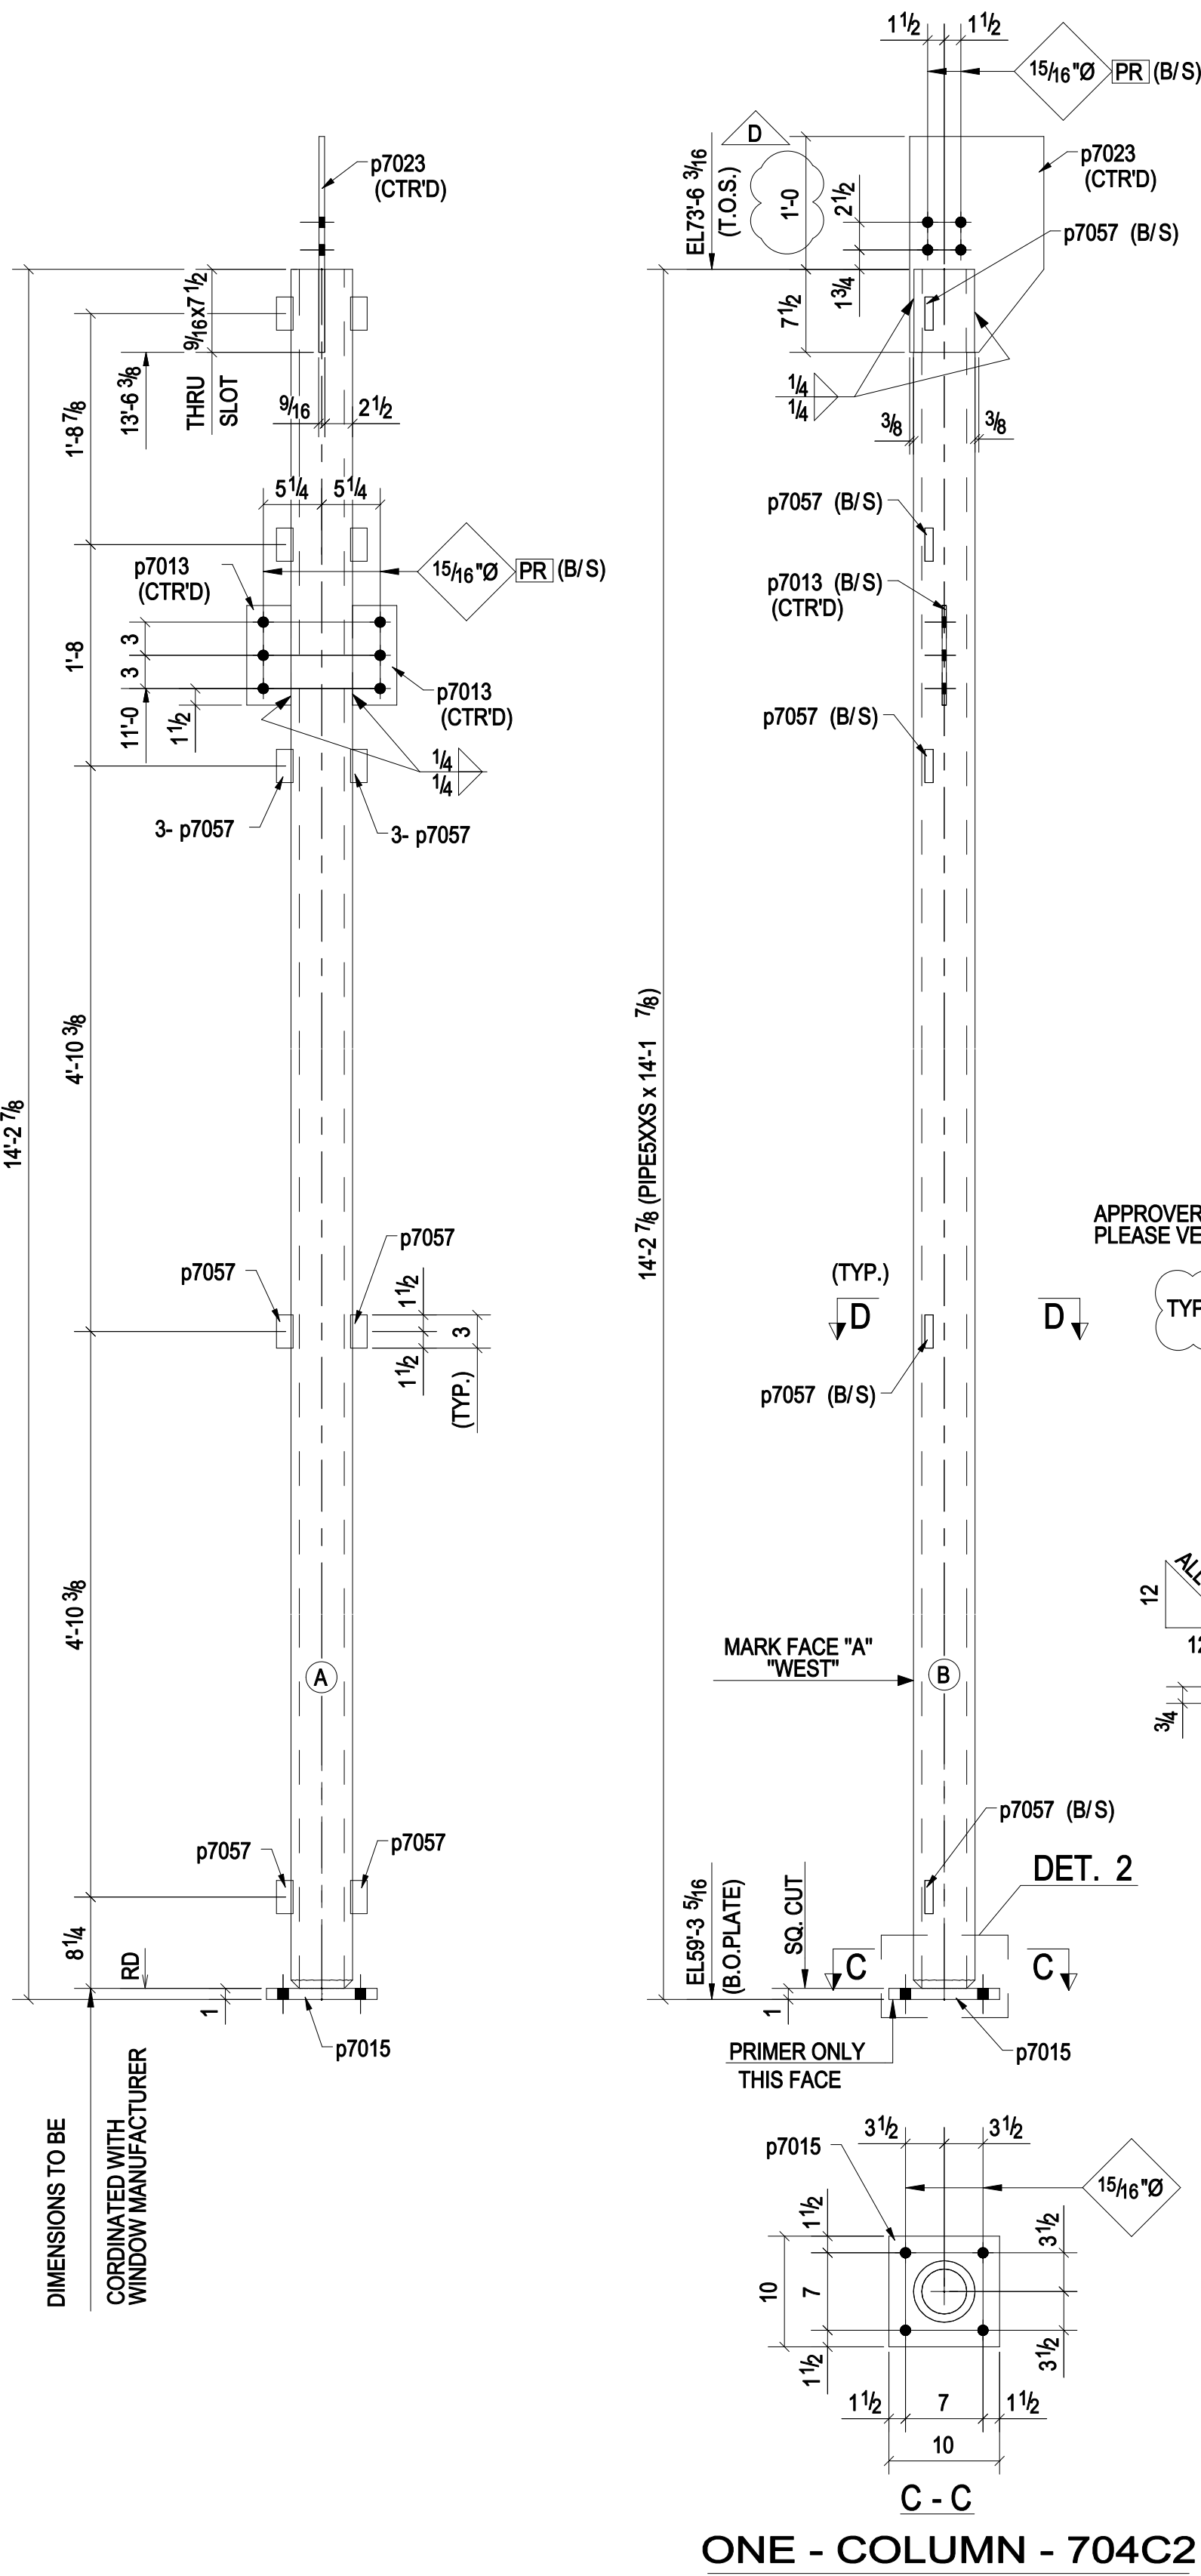

ONE - COLUMN - 704C2

SURFACE FINISH: SSPC-SP6

PAINT SYSTEM-1

- (i) PRIMER CARBOZINC 859 2.5 TO 3.5 MILS DFT.
- (ii) TOP COAT CARBOGUARD 893SG 4.0 TO 6.0 MILS DFT.
- (iii) COLOR UTILITY TOOLBOX C703 MEDIUM GRAY.